
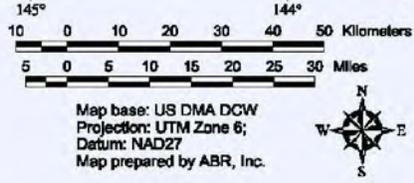


**APPENDIX A –  
MAPS**

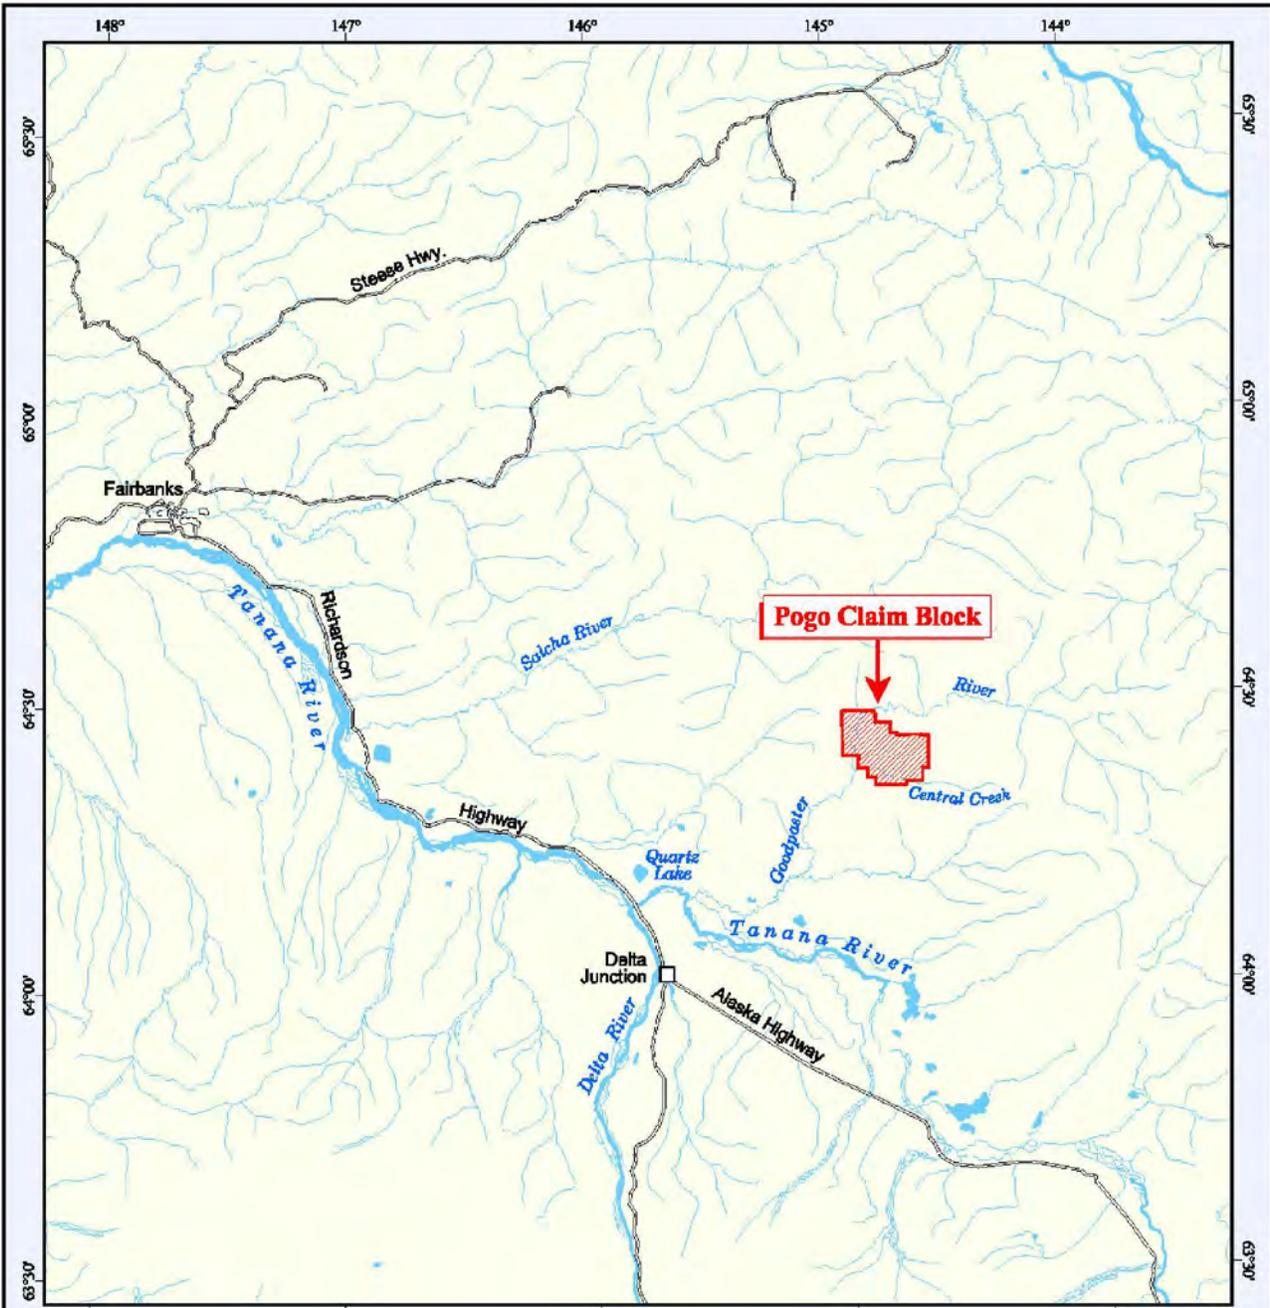

**POGO MINE**  
© 2013 POGO MINE AND FAIR MINING PEGGEE LLC


MINING DONE RIGHT

---

**Pogo Project**  
 Figure 1  
 General Location Map

---

March 2014
2013 Annual Activity Report

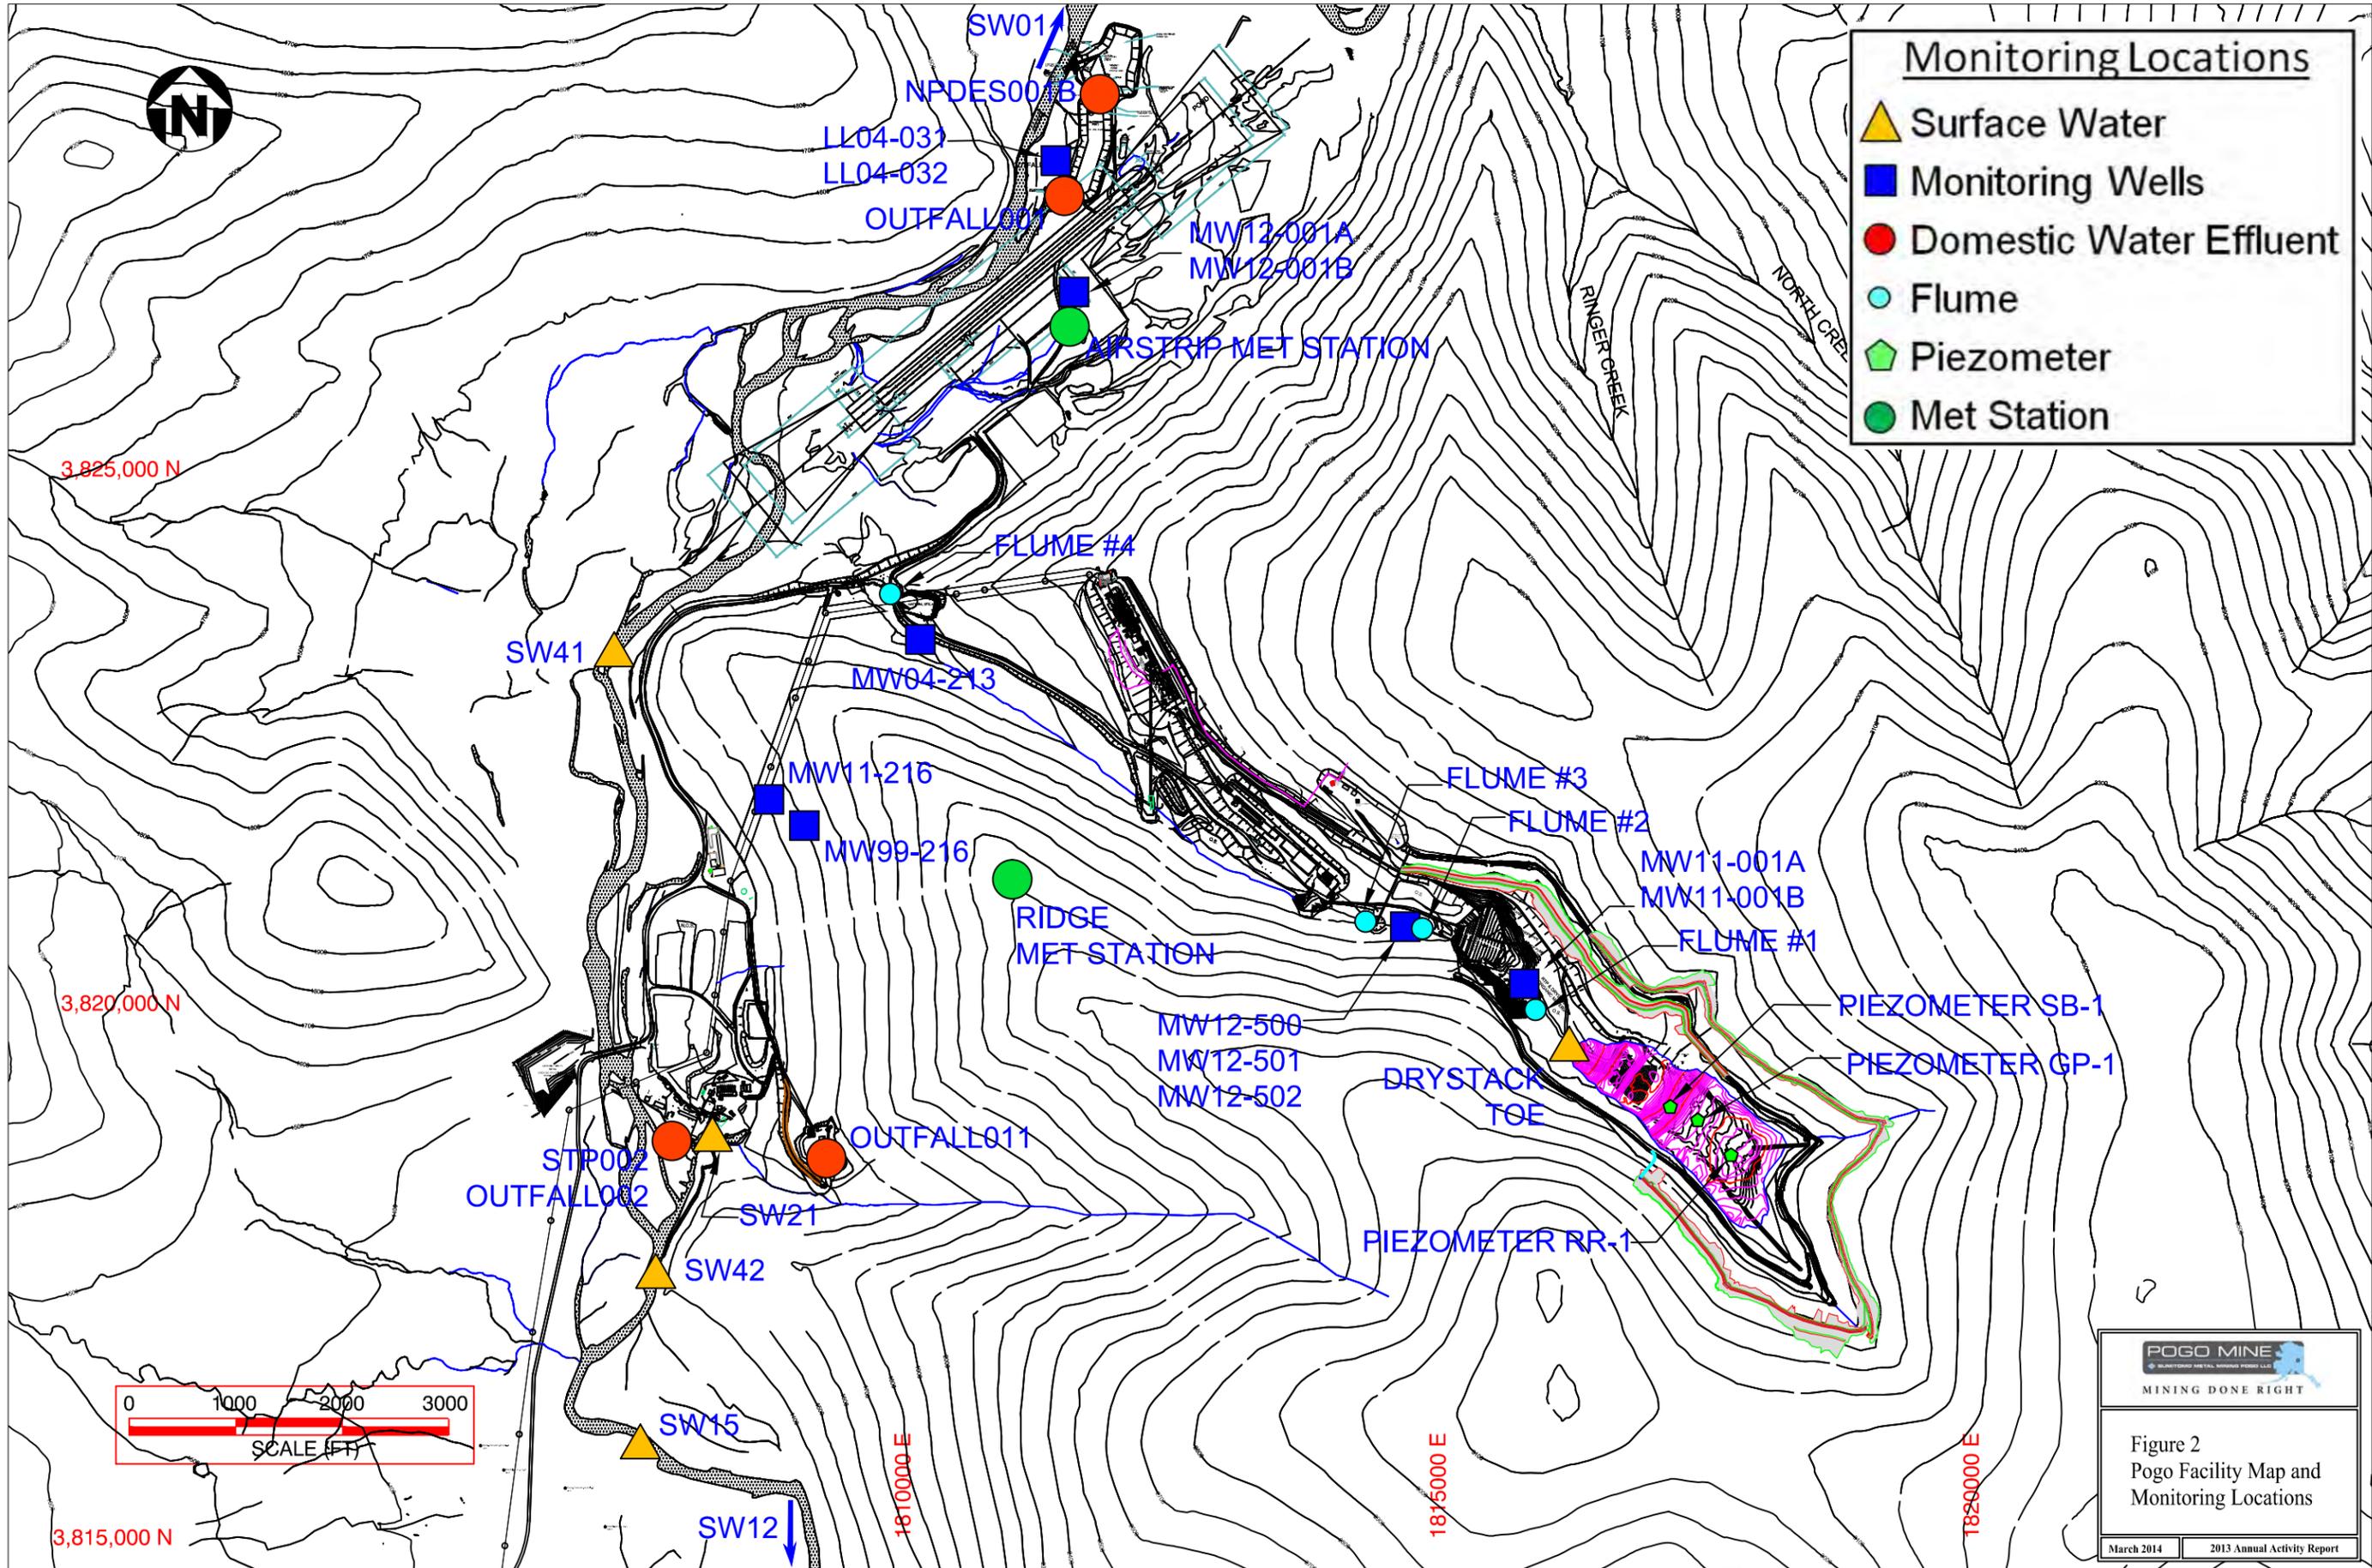

  
 MINING DONE RIGHT  
 Figure 2  
 Pogo Facility Map and  
 Monitoring Locations  
 March 2014 | 2013 Annual Activity Report


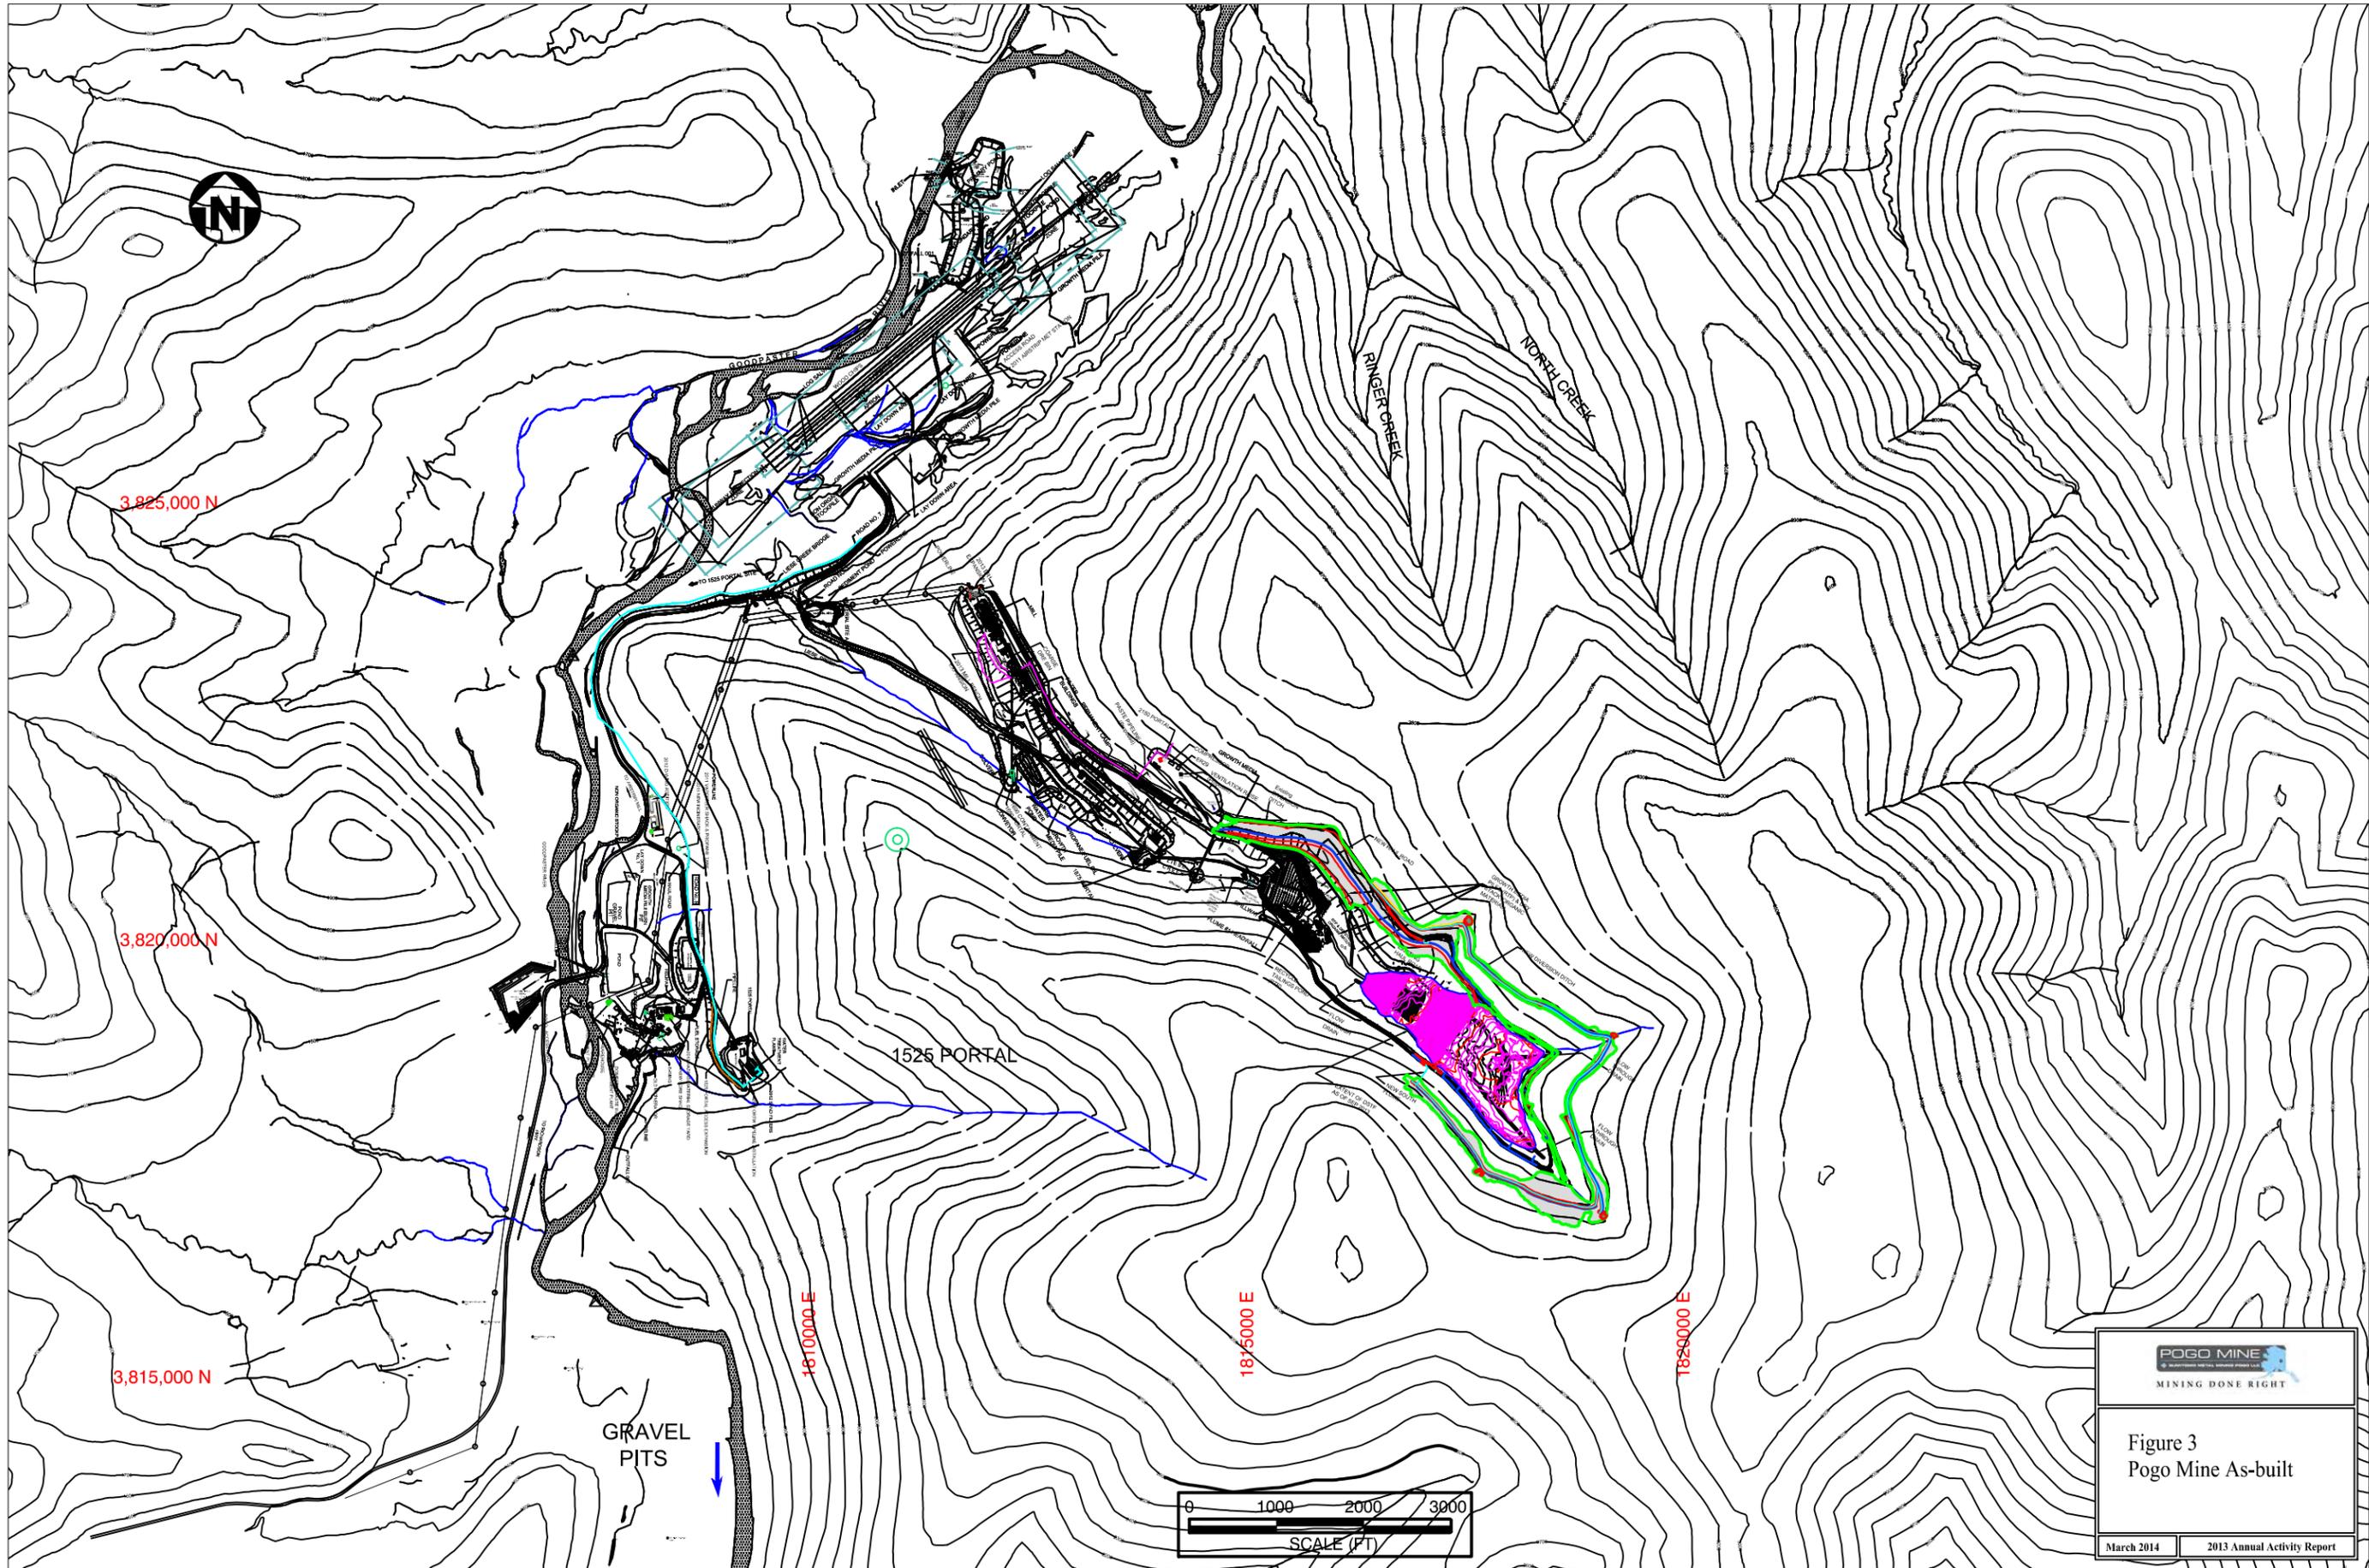


Figure 3  
Pogo Mine As-built

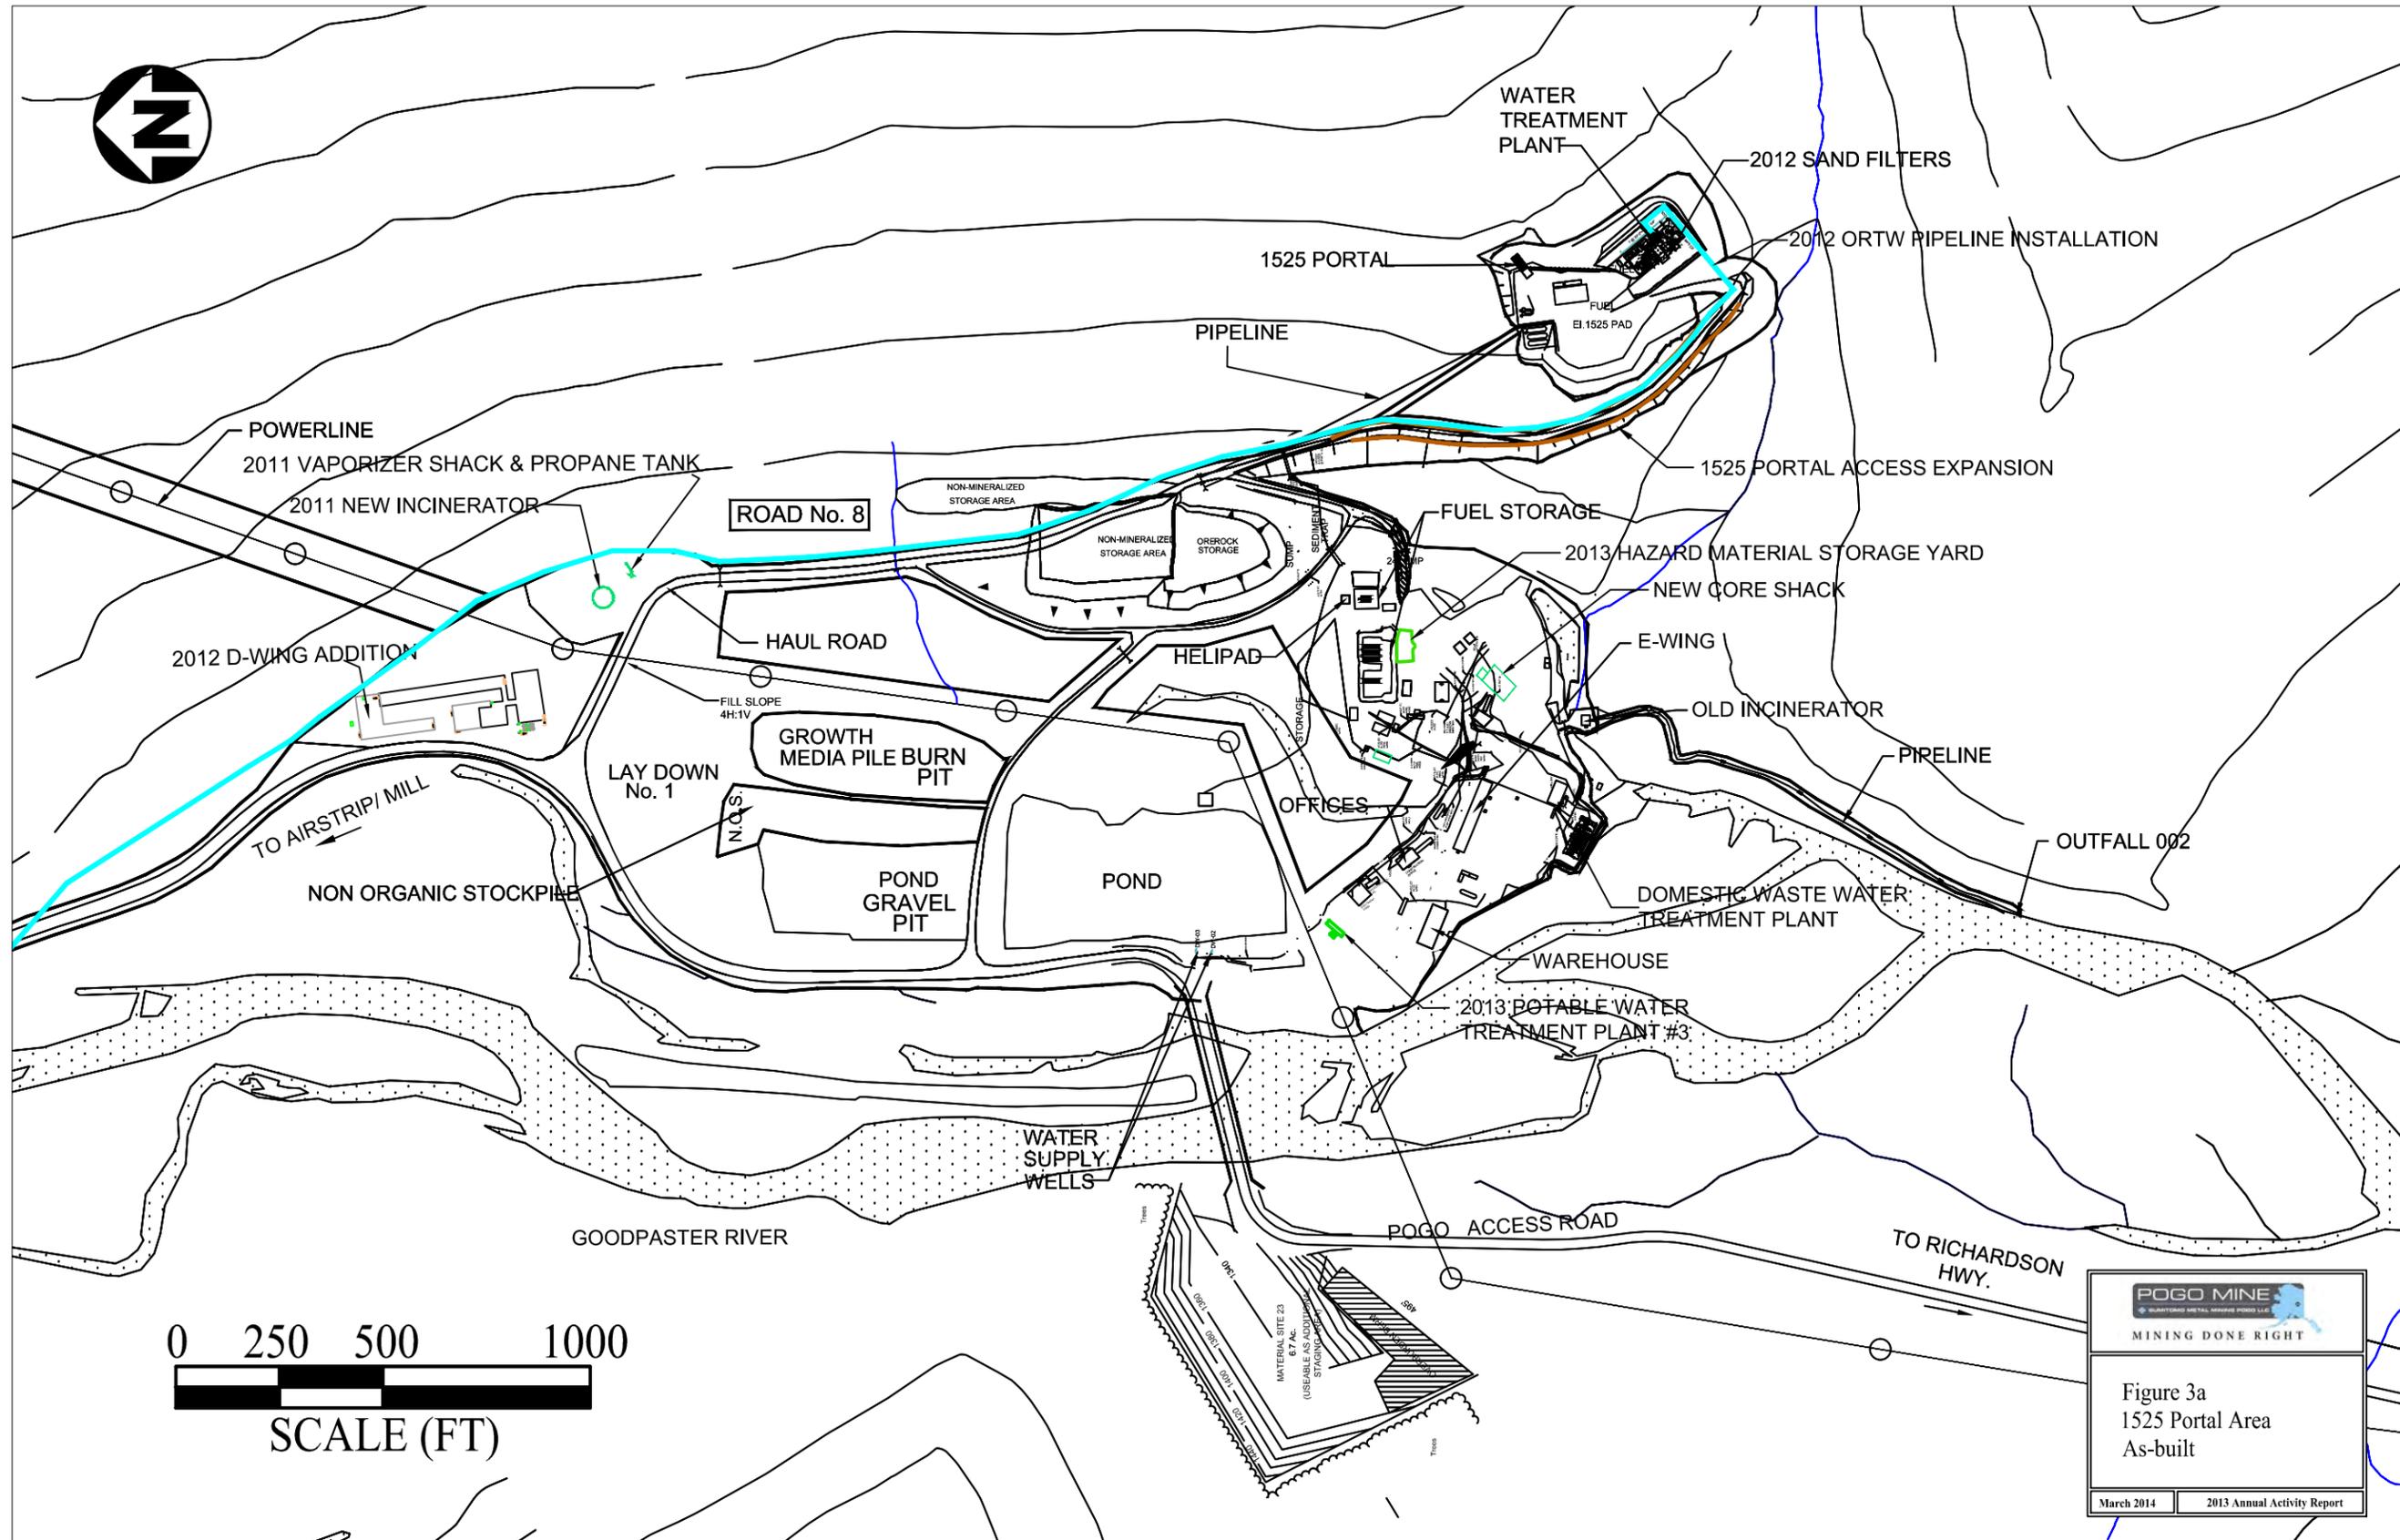


**POGO MINE**  
 MINING DONE RIGHT


Figure 3a  
 1525 Portal Area  
 As-built

March 2014      2013 Annual Activity Report



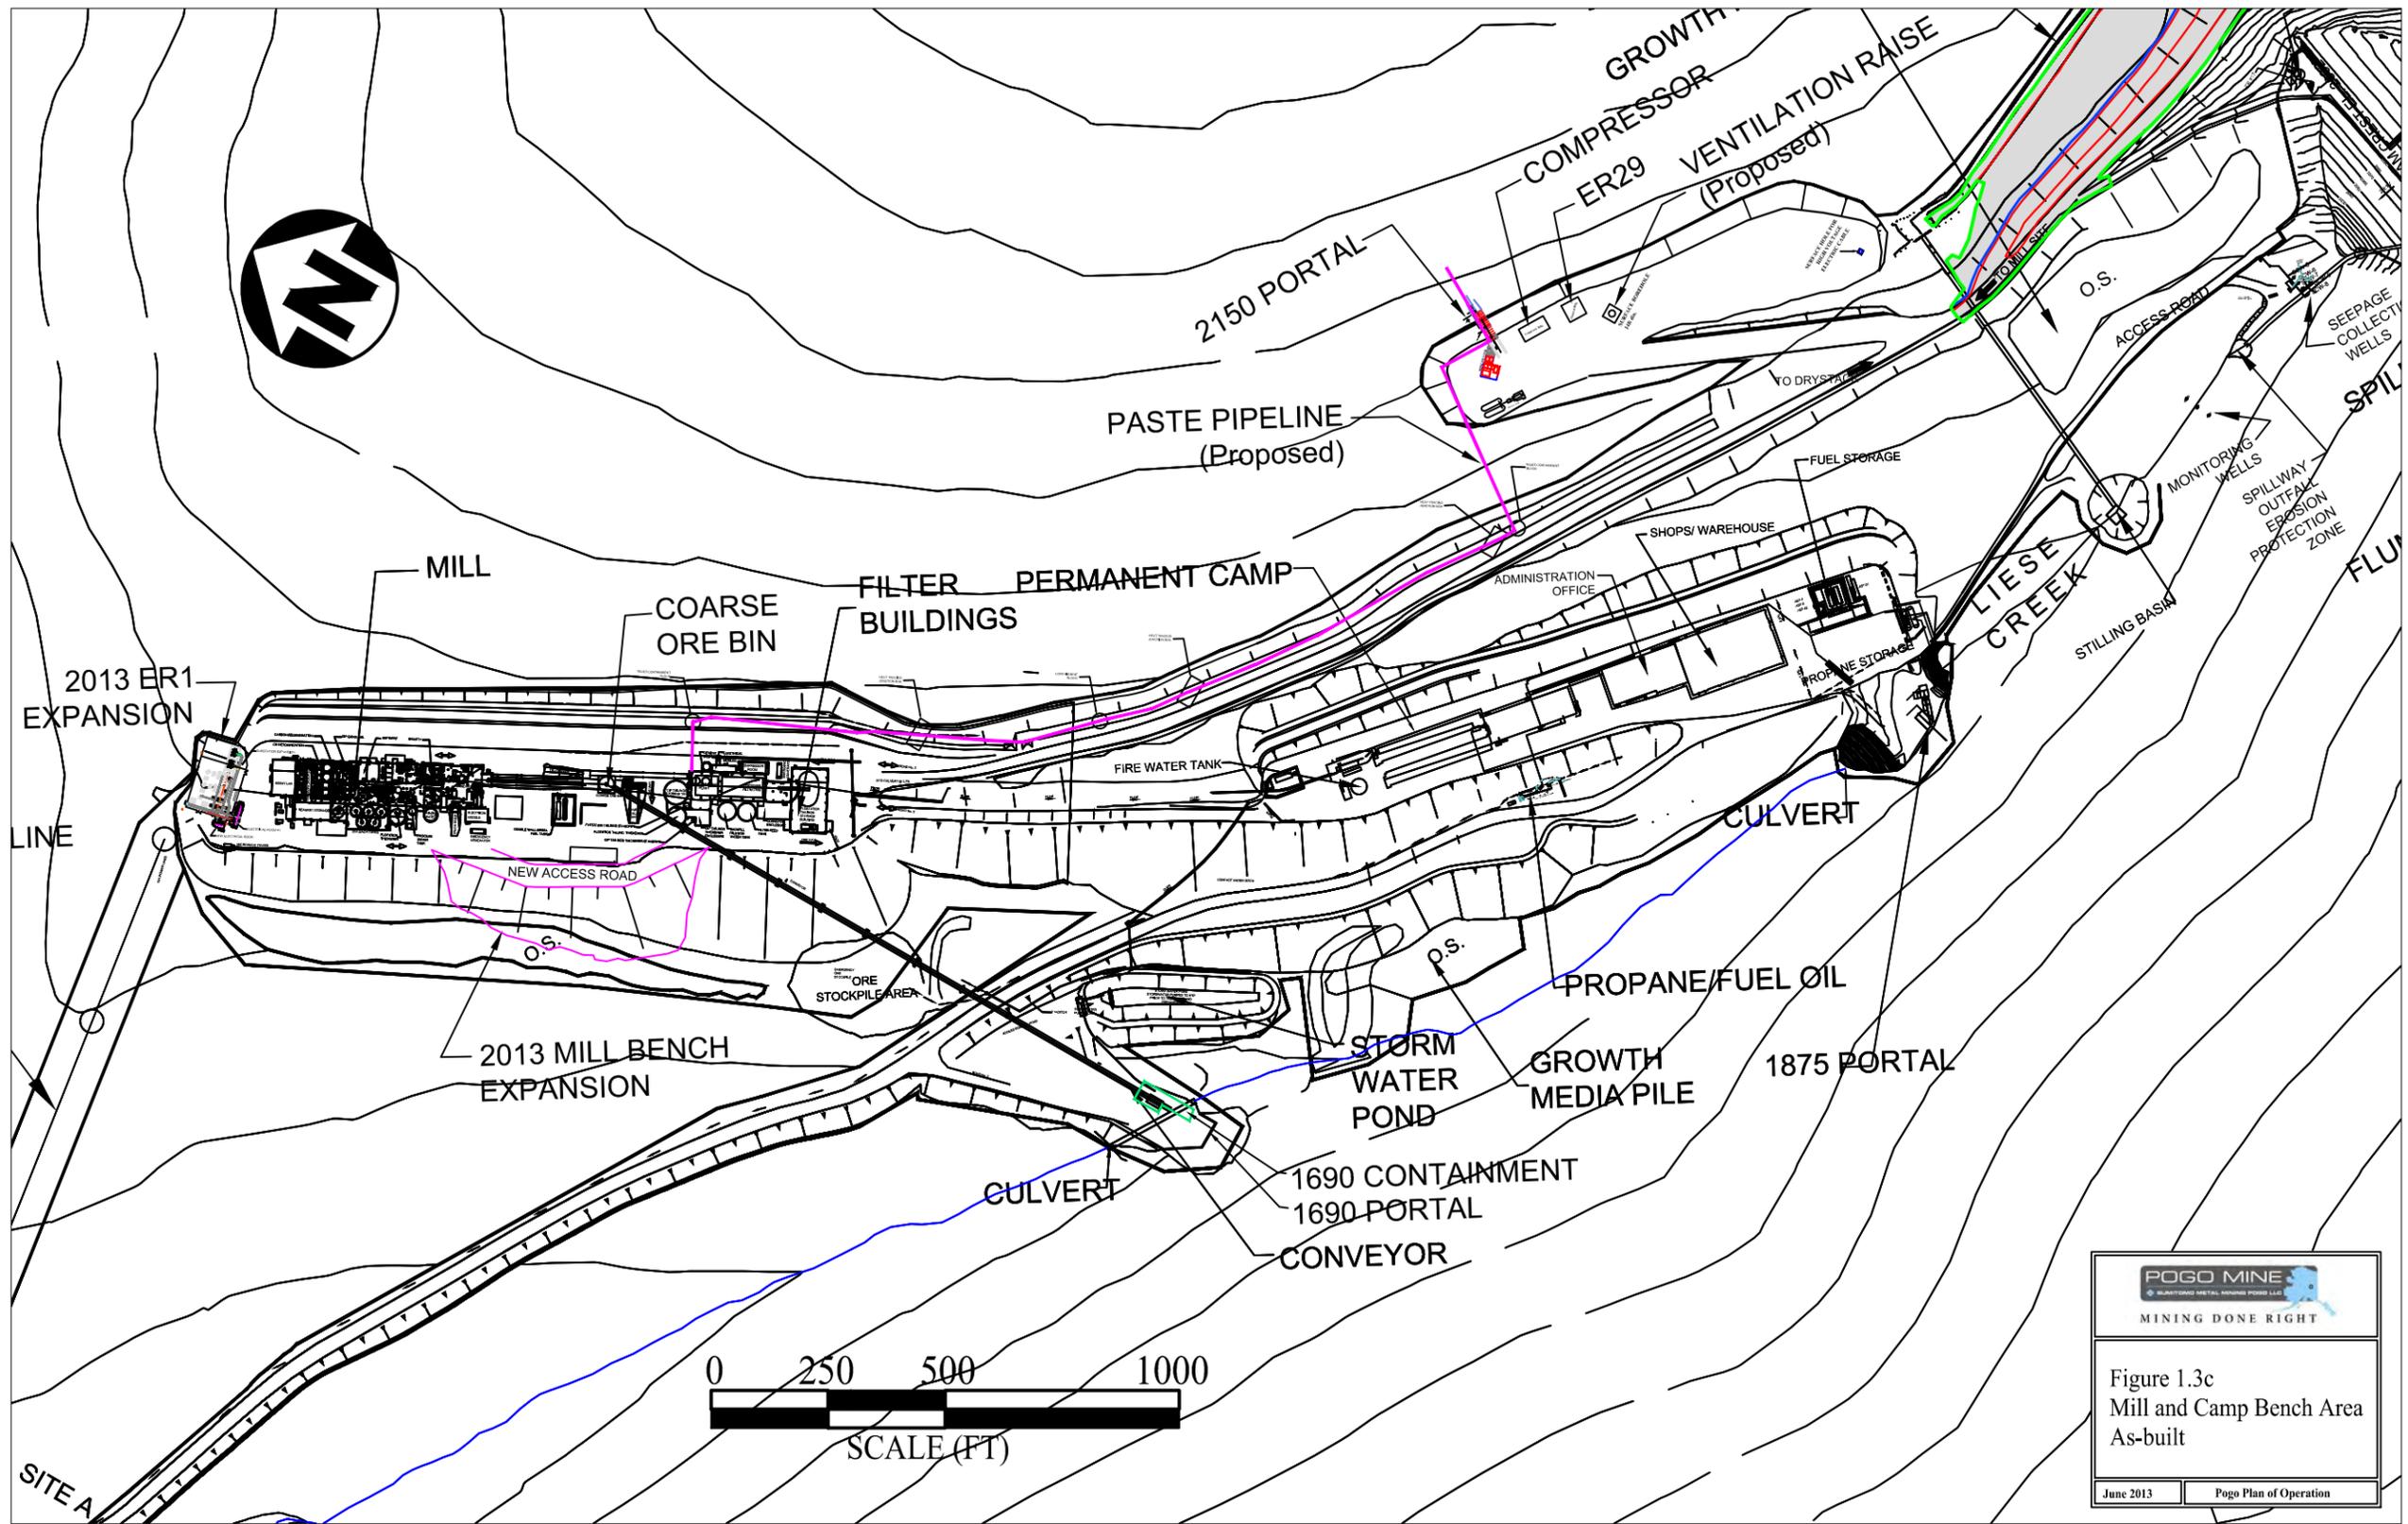


  
 MINING DONE RIGHT
   
 Figure 1.3c
   
 Mill and Camp Bench Area
   
 As-built
   
 June 2013      Pogo Plan of Operation

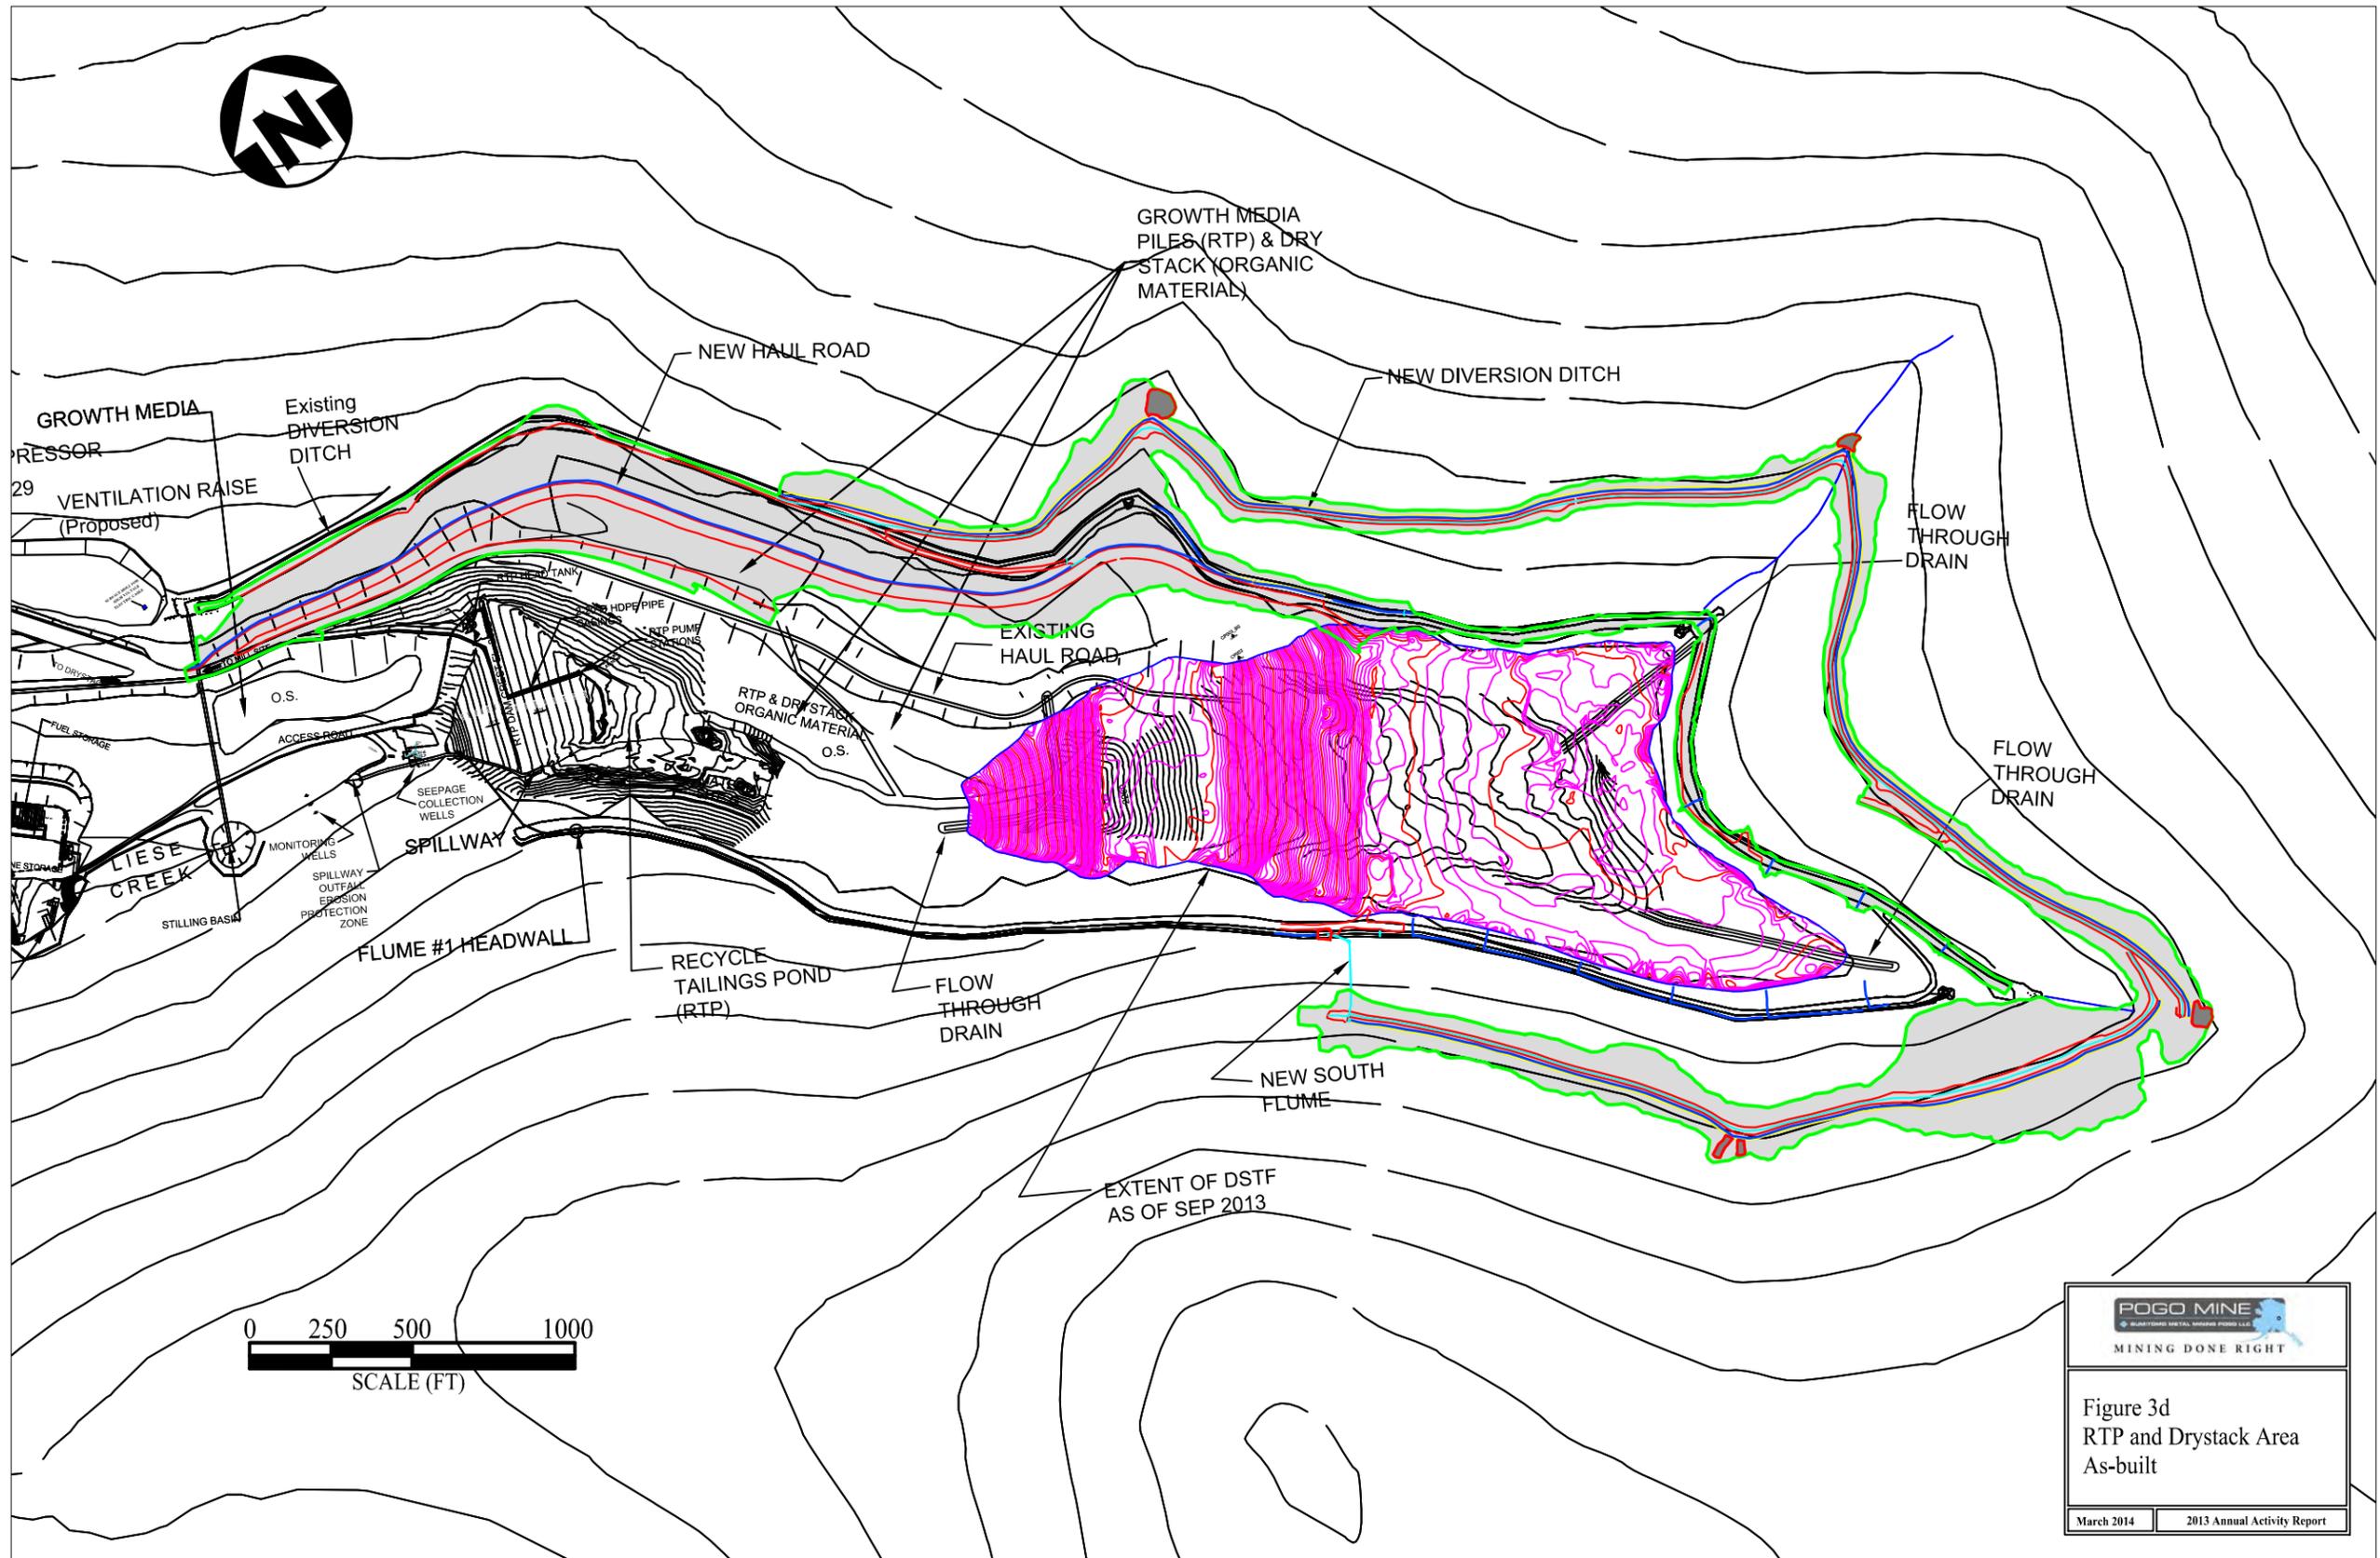

**POGO MINE**  
MINING DONE RIGHT

Figure 3d  
RTP and Drystack Area  
As-built

March 2014 | 2013 Annual Activity Report