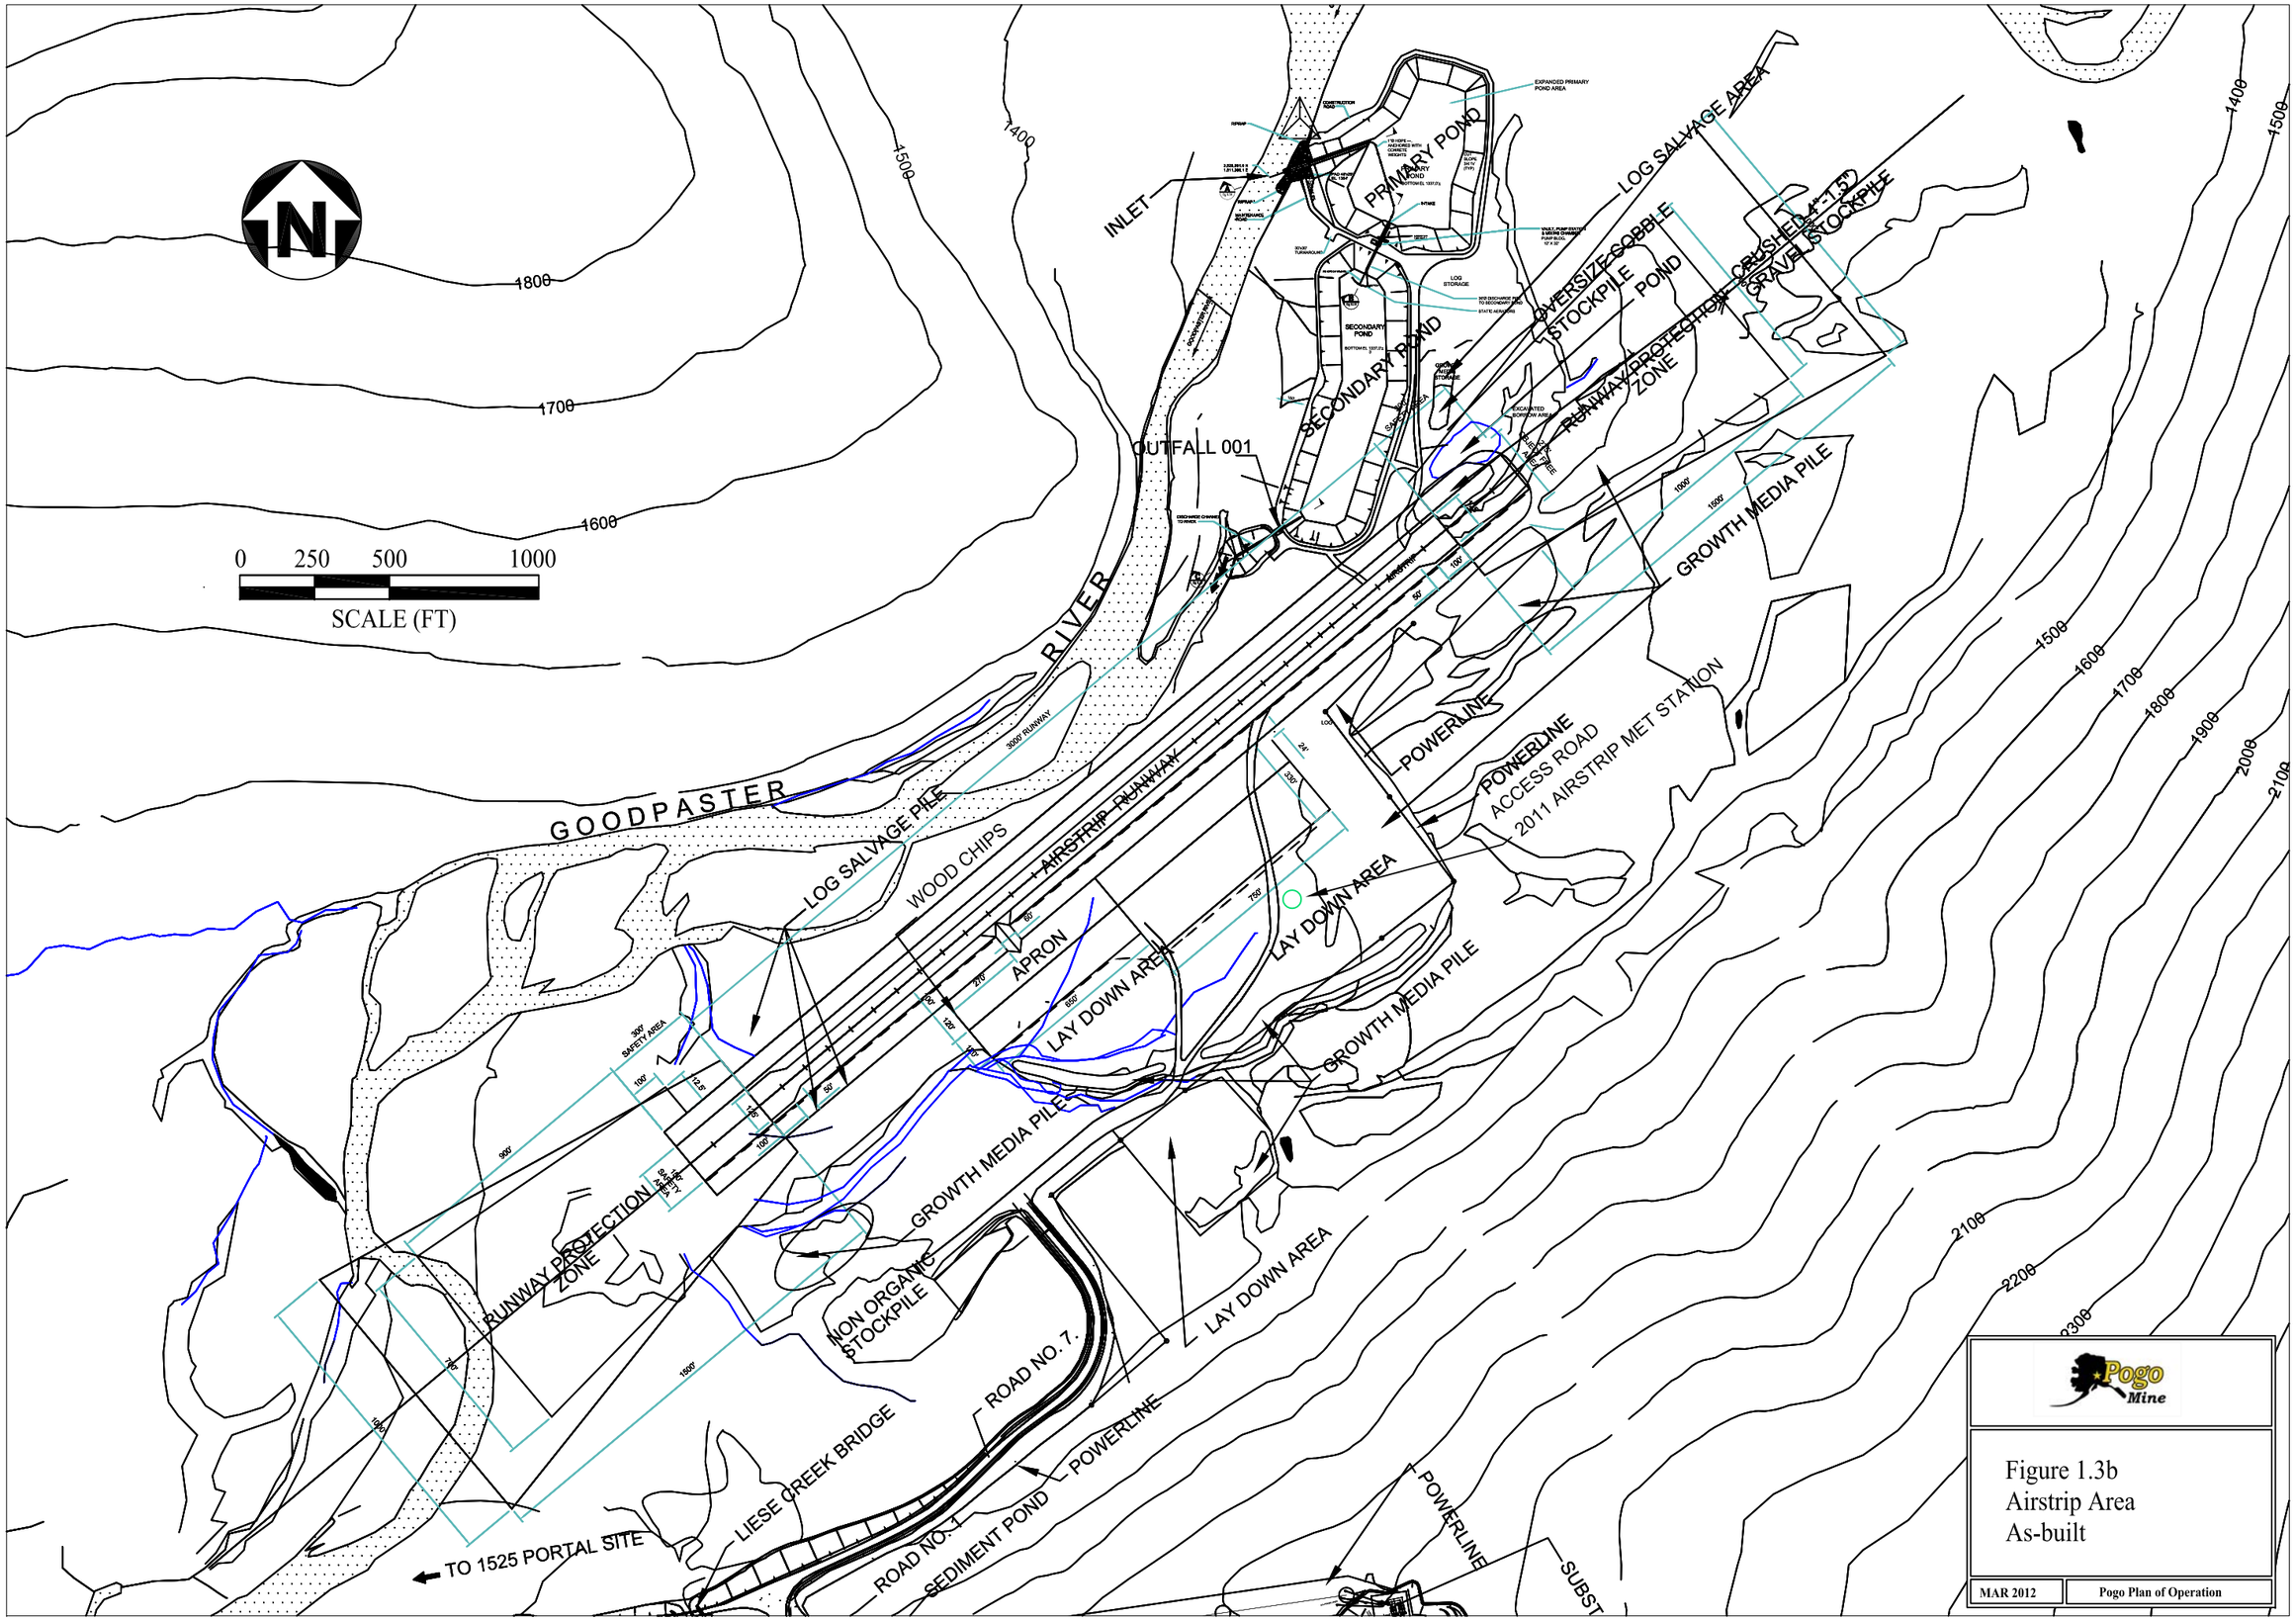

Pogo Mine

Figure 1.3b
Airstrip Area
As-built

MAR 2012	Pogo Plan of Operation